Lat: 47°37'6.43"N



Amazon - Fiona Building 500 Boren Avenue Seattle, WA 98109

September 19, 2013



Fiona Directional As-Built Record



NO SCALE 1ST LEVEL FLOOR PLAN



SEATTLE • SAN DIEGO

MAIN OFFICE 420 STEVENS AVENUE #270 SOLANA BEACH, CA 92075

PHONE: 858.345.1542 FAX: 858.408.3203

CLIENT INFORMATION:

Amazon **500 Boren Avenue N** Seattle, WA 98109



APPROVALS:

IG ACCOUNT MANAGER _

IG PRODUCTION MANAGER..... CLIENT APPROVAL.

SALES REP:

Bart Haynes

DESIGNER: R.Germar

REVISION DATES:



345

VOLTAGE:

120V 🗆 240V 🗆

THIS ORIGINAL UNPUBLISHED DESIGN IS THE SOLE PROPERTY OF IMAGE GROUP. IT CANNOT BE REPRODUCED, COPIED OR EXHIBITED IN WHOLE OR PART, WITHOUT FIRST OBTAINING WRITTEN CONSENT FROM IMAGE GROUP COLORS REPRESENTED IN THIS DRAWING ARE FOR PRESENTATION PURPOSES ONLY. THEY MAY NOT MATCH YOUR FINISHED PRODUCT PERFECTLY, COLOR CALL-OUTS ARE FOR REFERENCE PURPOSES ONLY.

PRIMARY ELECTRICAL TO SIGN LOCATIONS IS TO BE PROVIDED BY OTHERS. 20 AMP DEDICATED CIRCUIT (S) WITH NO SHARED NEUTRALS AND A GROUND RETURNING TO THE PANEL IS REQUIRED FOR ALL INSTALLATIONS. THIS SIGN IS INTENDED TO BE INSTALLED IN ACCORDANCE WITH THE REQUIREMENTS OF ARTICLE 600 OF THE NATIONAL ELECTRICAL CODE AND/OR OTHER APPLICABLE LOCAL CODES. THIS INCLUDES PROPER GROUNDING AND BONDING OF THE SIGN.

09-19-2013

DESIGN NO:

Fiona Directional As-Built Record

PROJECT LOCATION: Fiona Building

SIGN TYPE:

1st Level

Floor Plan

Page 2 of 6



2ND LEVEL FLOOR PLAN **NO SCALE**



SEATTLE • SAN DIEGO

MAIN OFFICE 420 STEVENS AVENUE #270 SOLANA BEACH, CA 92075

> PHONE: 858.345.1542 FAX: 858.408.3203

CLIENT INFORMATION:

Amazon **500 Boren Avenue N** Seattle, WA 98109

amazon

APPROVALS:

IG ACCOUNT MANAGER_ IG PRODUCTION MANAGER.....

CLIENT APPROVAL.

SALES REP: **Bart Haynes**

DESIGNER: R.Germar

REVISION DATES:

345

VOLTAGE:

120V □ 240V 🗆

THIS ORIGINAL UNPUBLISHED DESIGN IS THE SOLE PROPERTY OF IMAGE GROUP. IT CANNOT BE REPRODUCED, COPIED OR EXHIBITED IN WHOLE OR PART, WITHOUT FIRST OBTAINING WRITTEN CONSENT FROM IMAGE GROUP COLORS FROM IMAGE GROUP COLORS
REPRESENTED IN THIS DRAWING ARE
FOR PRESENTATION PURPOSES ONLY.
THEY MAY NOT MATCH YOUR FINISHED
PRODUCT PERFECTLY. COLOR CALL-OUTS
ARE FOR REFERENCE PURPOSES ONLY.

PRIMARY ELECTRICAL TO SIGN
LOCATIONS IS TO BE PROVIDED BY
OTHERS. 20 AMP DEDICATED CIRCUIT (S)
WITH NO SHARED NEUTRALS AND A
GROUND RETURNING TO THE PANIEL IS
REQUIRED FOR ALL INSTALLATIONS. THIS
SIGN IS INTENDED TO BE INSTALLED IN
ACCORDANCE WITH THE REQUIREMENTS
OF ARTICLE 600 OF THE NATIONAL
ELECTRICAL CODE AND/OR OTHER
APPLICABLE LOCAL CODES. THIS
INCLUDES PROPER GROUNDING AND
BONDING OF THE SIGN.

09-19-2013

DESIGN NO: Fiona Directional As-Built Record

PROJECT LOCATION:

Fiona Building SIGN TYPE:

2nd Level Floor Plan

Page 3 of 6



3RD LEVEL FLOOR PLAN NO SCALE



SEATTLE • SAN DIEGO

MAIN OFFICE 420 STEVENS AVENUE #270 SOLANA BEACH, CA 92075

> PHONE: 858.345.1542 FAX: 858.408.3203

CLIENT INFORMATION:

Amazon **500 Boren Avenue N** Seattle, WA 98109

amazon

APPROVALS:

IG ACCOUNT MANAGER _ IG PRODUCTION MANAGER.....

CLIENT APPROVAL.

SALES REP: **Bart Haynes**

DESIGNER: R.Germar

REVISION DATES:

345

VOLTAGE:

120V □ 240V 🗆

THIS ORIGINAL UNPUBLISHED DESIGN IS THE SOLE PROPERTY OF IMAGE GROUP. IT CANNOT BE REPRODUCED, COPIED OR EXHIBITED IN WHOLE OR PART, WITHOUT FIRST OBTAINING WRITTEN CONSENT FROM IMAGE GROUP COLORS HOW IMAGE GROUP COLORS
REPRESENTED IN THIS DRAWING ARE
FOR PRESENTATION PURPOSES ONLY.
THEY MAY NOT MATCH YOUR FINISHED
PRODUCT PERFECTLY, COLOR CALL-OUTS
ARE FOR REFERENCE PURPOSES ONLY.

PRIMARY ELECTRICAL TO SIGN
LOCATIONS IS TO BE PROVIDED BY
OTHERS. 20 AMP DEDICATED CIRCUIT (S)
WITH NO SHARED NEUTRALS AND A
GROUND RETURNING TO THE PANIEL IS
REQUIRED FOR ALL INSTALLATIONS. THIS
SIGN IS INTENDED TO BE INSTALLED IN
ACCORDANCE WITH THE REQUIREMENTS
OF ARTICLE 600 OF THE NATIONAL
ELECTRICAL CODE AND/OR OTHER
APPLICABLE LOCAL CODES. THIS
INCLUDES PROPER GROUNDING AND
BONDING OF THE SIGN.

09-19-2013

DESIGN NO: Fiona Directional As-Built Record

PROJECT LOCATION:

Fiona Building SIGN TYPE:

3rd Level Floor Plan

Page 4 of 6



4TH LEVEL FLOOR PLAN **NO SCALE**



SEATTLE • SAN DIEGO

MAIN OFFICE 420 STEVENS AVENUE #270 SOLANA BEACH, CA 92075

> PHONE: 858.345.1542 FAX: 858.408.3203

CLIENT INFORMATION:

Amazon **500 Boren Avenue N** Seattle, WA 98109

amazon

APPROVALS:

IG ACCOUNT MANAGER _ IG PRODUCTION MANAGER.....

CLIENT APPROVAL.

SALES REP: **Bart Haynes**

DESIGNER: R.Germar

REVISION DATES:

345

VOLTAGE:

120V □ 240V 🗆

THIS ORIGINAL UNPUBLISHED DESIGN IS THE SOLE PROPERTY OF IMAGE GROUP. IT CANNOT BE REPRODUCED, COPIED OR EXHIBITED IN WHOLE OR PART, WITHOUT FIRST OBTAINING WRITTEN CONSENT FROM IMAGE GROUP COLORS FROM IMAGE GROUP COLORS
REPRESENTED IN THIS DRAWING ARE
FOR PRESENTATION PURPOSES ONLY.
THEY MAY NOT MATCH YOUR FINISHED
PRODUCT PERFECTLY. COLOR CALL-OUTS
ARE FOR REFERENCE PURPOSES ONLY.

PRIMARY ELECTRICAL TO SIGN
LOCATIONS IS TO BE PROVIDED BY
OTHERS. 20 AMP DEDICATED CIRCUIT (S)
WITH NO SHARED NEUTRALS AND A
GROUND RETURNING TO THE PANIEL IS
REQUIRED FOR ALL INSTALLATIONS. THIS
SIGN IS INTENDED TO BE INSTALLED IN
ACCORDANCE WITH THE REQUIREMENTS
OF ARTICLE 600 OF THE NATIONAL
ELECTRICAL CODE AND/OR OTHER
APPLICABLE LOCAL CODES. THIS
INCLUDES PROPER GROUNDING AND
BONDING OF THE SIGN.

09-19-2013


DESIGN NO: Fiona Directional As-Built Record

PROJECT LOCATION:

Fiona Building SIGN TYPE:

4th Level Floor Plan

Page **5** of **6**

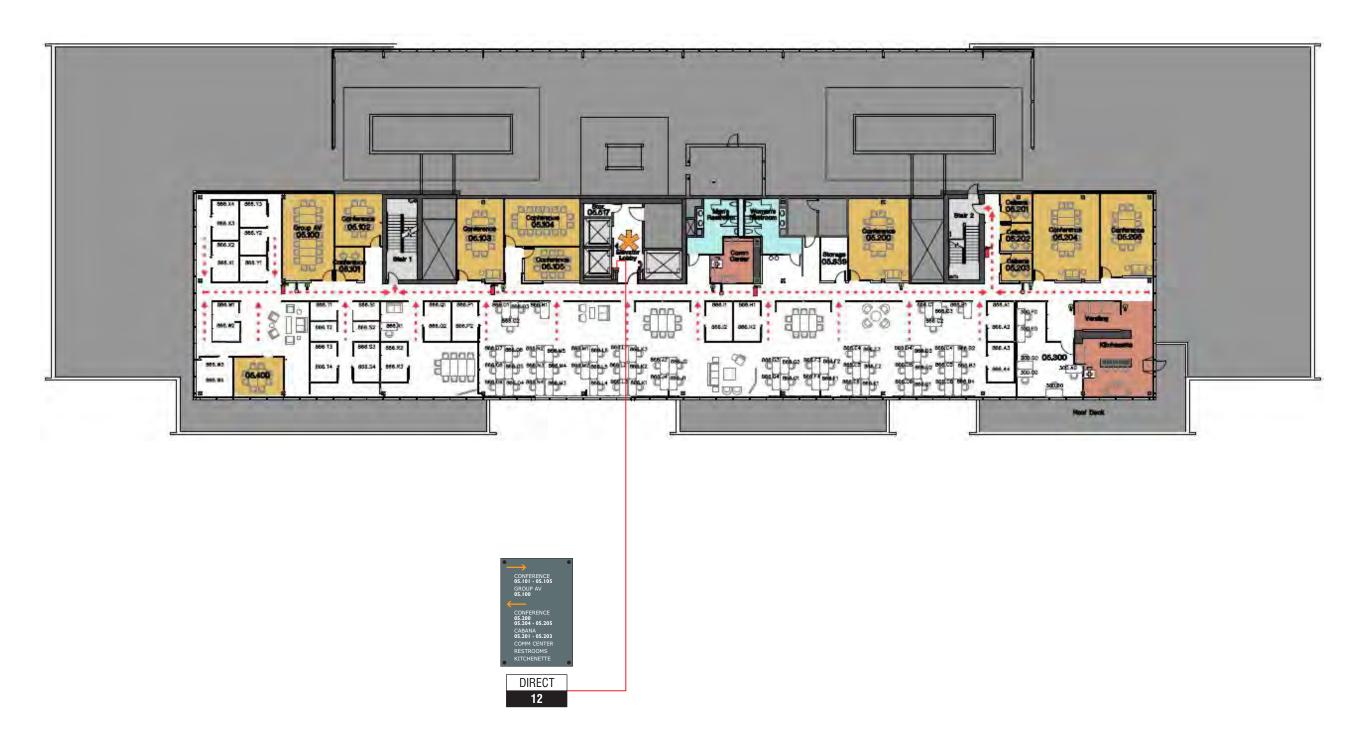

5TH LEVEL FLOOR PLAN NO SCALE



SEATTLE • SAN DIEGO

MAIN OFFICE 420 STEVENS AVENUE #270 SOLANA BEACH, CA 92075

PHONE: 858.345.1542 FAX: 858.408.3203

CLIENT INFORMATION:

Amazon **500 Boren Avenue N** Seattle, WA 98109



APPROVALS:

IG ACCOUNT MANAGER_

IG PRODUCTION MANAGER..... CLIENT APPROVAL.

SALES REP: **Bart Haynes**

DESIGNER: R.Germar

REVISION DATES:





VOLTAGE:

120V 🗆 240V 🔲

THIS ORIGINAL UNPUBLISHED DESIGN IS THE SOLE PROPERTY OF IMAGE GROUP. IT CANNOT BE REPRODUCED, COPIED OR EXHIBITED IN WHOLE OR PART, WITHOUT FIRST OBTAINING WRITTEN CONSENT FROM IMAGE GROUP. COLORS REPRESENTED IN THIS DRAWING ARE FOR PRESENTATION PURPOSES ONLY. THEY MAY NOT MATCH YOUR FINISHED PRODUCT PERFECTLY. COLOR CALL-OUTS ARE FOR REFERENCE PURPOSES ONLY.

PRIMARY ELECTRICAL TO SIGN
LOCATIONS IS TO BE PROVIDED BY
OTHERS. 20 AMP DEDICATED CIRCUIT (S)
WITH NO SHARED NEUTRALS AND A
GROUND RETURNING TO THE PANEL IS
REQUIRED FOR ALL INSTALLATIONS. THIS
SIGN IS INTENDED TO BE INSTALLED IN
ACCORDANCE WITH THE REQUIREMENTS
OF ARTICLE 600 OF THE NATIONAL
ELECTRICAL CODE AND/OR OTHER
APPLICABLE LOCAL CODES. THIS
INCLUDES PROPER GROUNDING AND
BONDING OF THE SIGN.

09-19-2013

DESIGN NO:

Fiona Directional As-Built Record

PROJECT LOCATION:

Fiona Building SIGN TYPE:

5th Level **Floor Plan**

Page 6 of 6

